Exhibit B

Pavement spec

EXISTING LEGEND

- EXISTING MINOR CONTOUR
- EXISTING MAJOR CONTOUR
- EXISTING WATER MAIN
- EXISTING SANITARY SEWER MAIN
- EXISTING GAS
- EXISTING TELEPHONE
- EXISTING UNDERGROUND ELECTRIC
- EXISTING OVERHEAD ELECTRIC
- EXISTING CABLE
- EXISTING FIBER OPTIC
- EXISTING IRRIGATION PIPE
- EXISTING SWALE OR DITCH
- EXISTING STORM SEWER
- EXISTING EASEMENT
- EXISTING PROPERTY LINE
- EXISTING WIRE FENCE
- EXISTING ROCK WALL
- EXISTING ELECTRIC MANHOLE
- EXISTING DRAINAGE DRY-WELL
- EXISTING SEWER MANHOLE
- EXISTING TELEPHONE MANHOLE
- EXISTING UTILITY MANHOLE
- EXISTING GUY WIRE
- EXISTING POWER POLE
- EXISTING FIRE HYDRANT
- EXISTING WATER VALVE
- EXISTING CURB STOP
- EXISTING GAS METER
- EXISTING ELECTRIC TRANSFORMER
- EXISTING ELECTRIC METER
- EXISTING TELEPHONE PEDESTAL
- EXISTING CATV PEDESTAL
- EXISTING SEWER CLEANOUT
- EXISTING LIGHT POLE
- EXISTING SIGN
- EXISTING STORM INLET

PROPOSED LEGEND

- PROPOSED MINOR CONTOUR
- PROPOSED MAJOR CONTOUR
- PROPOSED WATER MAIN
- PROPOSED WATER MAIN
- PROPOSED SANITARY SEWER MAIN
- PROPOSED GAS
- PROPOSED TELEPHONE
- PROPOSED UNDERGROUND ELECTRIC
- PROPOSED OVERHEAD ELECTRIC
- PROPOSED CABLE
- PROPOSED FIBER OPTIC
- PROPOSED IRRIGATION PIPE
- PROPOSED SWALE OR DITCH
- PROPOSED STORM SEWER
- PROPOSED RETAINING WALL
- PROPOSED FENCE
- PROPOSED SEDIMENT CONTROL LOG
- PROPOSED SILT FENCE
- EXISTING SURFACE (PROFILE)
- FINISHED GRADE (PROFILE)
- PROPOSED INLET PROTECTION
- PROPOSED STABILIZED PARKING AREA
- PROPOSED ELECTRIC MANHOLE
- PROPOSED DRAINAGE DRY-WELL
- PROPOSED SEWER MANHOLE
- PROPOSED TELEPHONE MANHOLE
- PROPOSED UTILITY MANHOLE
- PROPOSED GUY WIRE
- PROPOSED POWER POLE
- PROPOSED FIRE HYDRANT
- PROPOSED WATER VALVE
- PROPOSED CURB STOP
- PROPOSED GAS METER/VALVE
- PROPOSED ELECTRIC TRANSFORMER
- PROPOSED ELECTRIC METER
- PROPOSED TELEPHONE PEDESTAL
- PROPOSED CATV PEDESTAL
- PROPOSED SEWER CLEANOUT
- PROPOSED LIGHT POLE
- PROPOSED SIGN
- PROPOSED STORM INLET

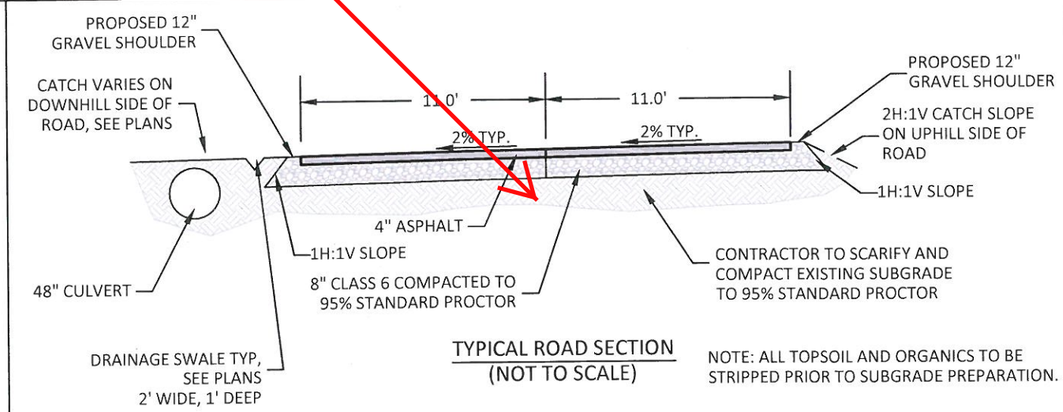

TYPICAL ROAD SECTION
(NOT TO SCALE)

NOTE: ALL TOPSOIL AND ORGANICS TO BE STRIPPED PRIOR TO SUBGRADE PREPARATION.

SUMMARY OF PROJECT QUANTITIES

CONTRACT ITEM DESCRIPTION	UNITS	PROJECT TOTALS PLAN	PROJECT TOTALS AS CONSTR.
CLEARING AND GRUBBING	LS	1	
REMOVAL OF FENCE	LF	80	
RESET MAILBOX STRUCTURE	EA	1	
RESET UTILITY SERVICE PEDESTAL	EA	1	
LANDSCAPE RESTORATION INCLUDING TOPSOIL	LS	1	
SILT FENCE	LF	160	
AGGREGATE BASE COURSE (CLASS 6)	TON	268	
HOT MIX ASPHALT (GRADING S) (75) (PG 64-22)	TON	110	
RIPRAP HEADWALL END SECTION	EA	1	
48" HDPE DRAINAGE PIPE	LF	86	
CONSTRUCTION SURVEYING OBSERVATION, TESTING AND AS BUILTS	LS	1	
MOBILIZATION	LS	1	
TRAFFIC CONTROL	LS	1	
F/A MINOR CONTRACT REVISIONS	FA	1	

COLORADO REGISTERED PROFESSIONAL ENGINEER
NANCY K. NEUMANN
28377
9/21/2015

Computer File Information	
Creation Date: OCTOBER, 2014	Initials: NEK
Last Modification Date: 9/21/15	Initials: KTS (R-X)
Full Path: G:\2014\14112\CIVIL\CIVIL DWGS\PLOT	(R-X)
Drawing File Name: 14112-NOTES_DET.DWG	(R-X)
CAD Ver.: CIVIL 3D 2014 Scale: Not to Scale Units: English	(R-X)

Sheet Revisions	
Date:	Comments

SOPRIS ENGINEERING, LLC.
CIVIL CONSULTANTS
502 MAIN STREET
CARBONDALE, CO 81623
(970) 704-0311
FAX: (970)-704-0313

LEGEND, DETAILS, AND QUANTITIES

DESIGNER: NEK
DETAILER: NEK
REVIEW: YTN

SOPRIS JOB #14112

PERMIT #314123

LOCATED ON SH 82 FRONTAGE ROAD AT MP 23.33 RIGHT

Sheet No. C4 of 11